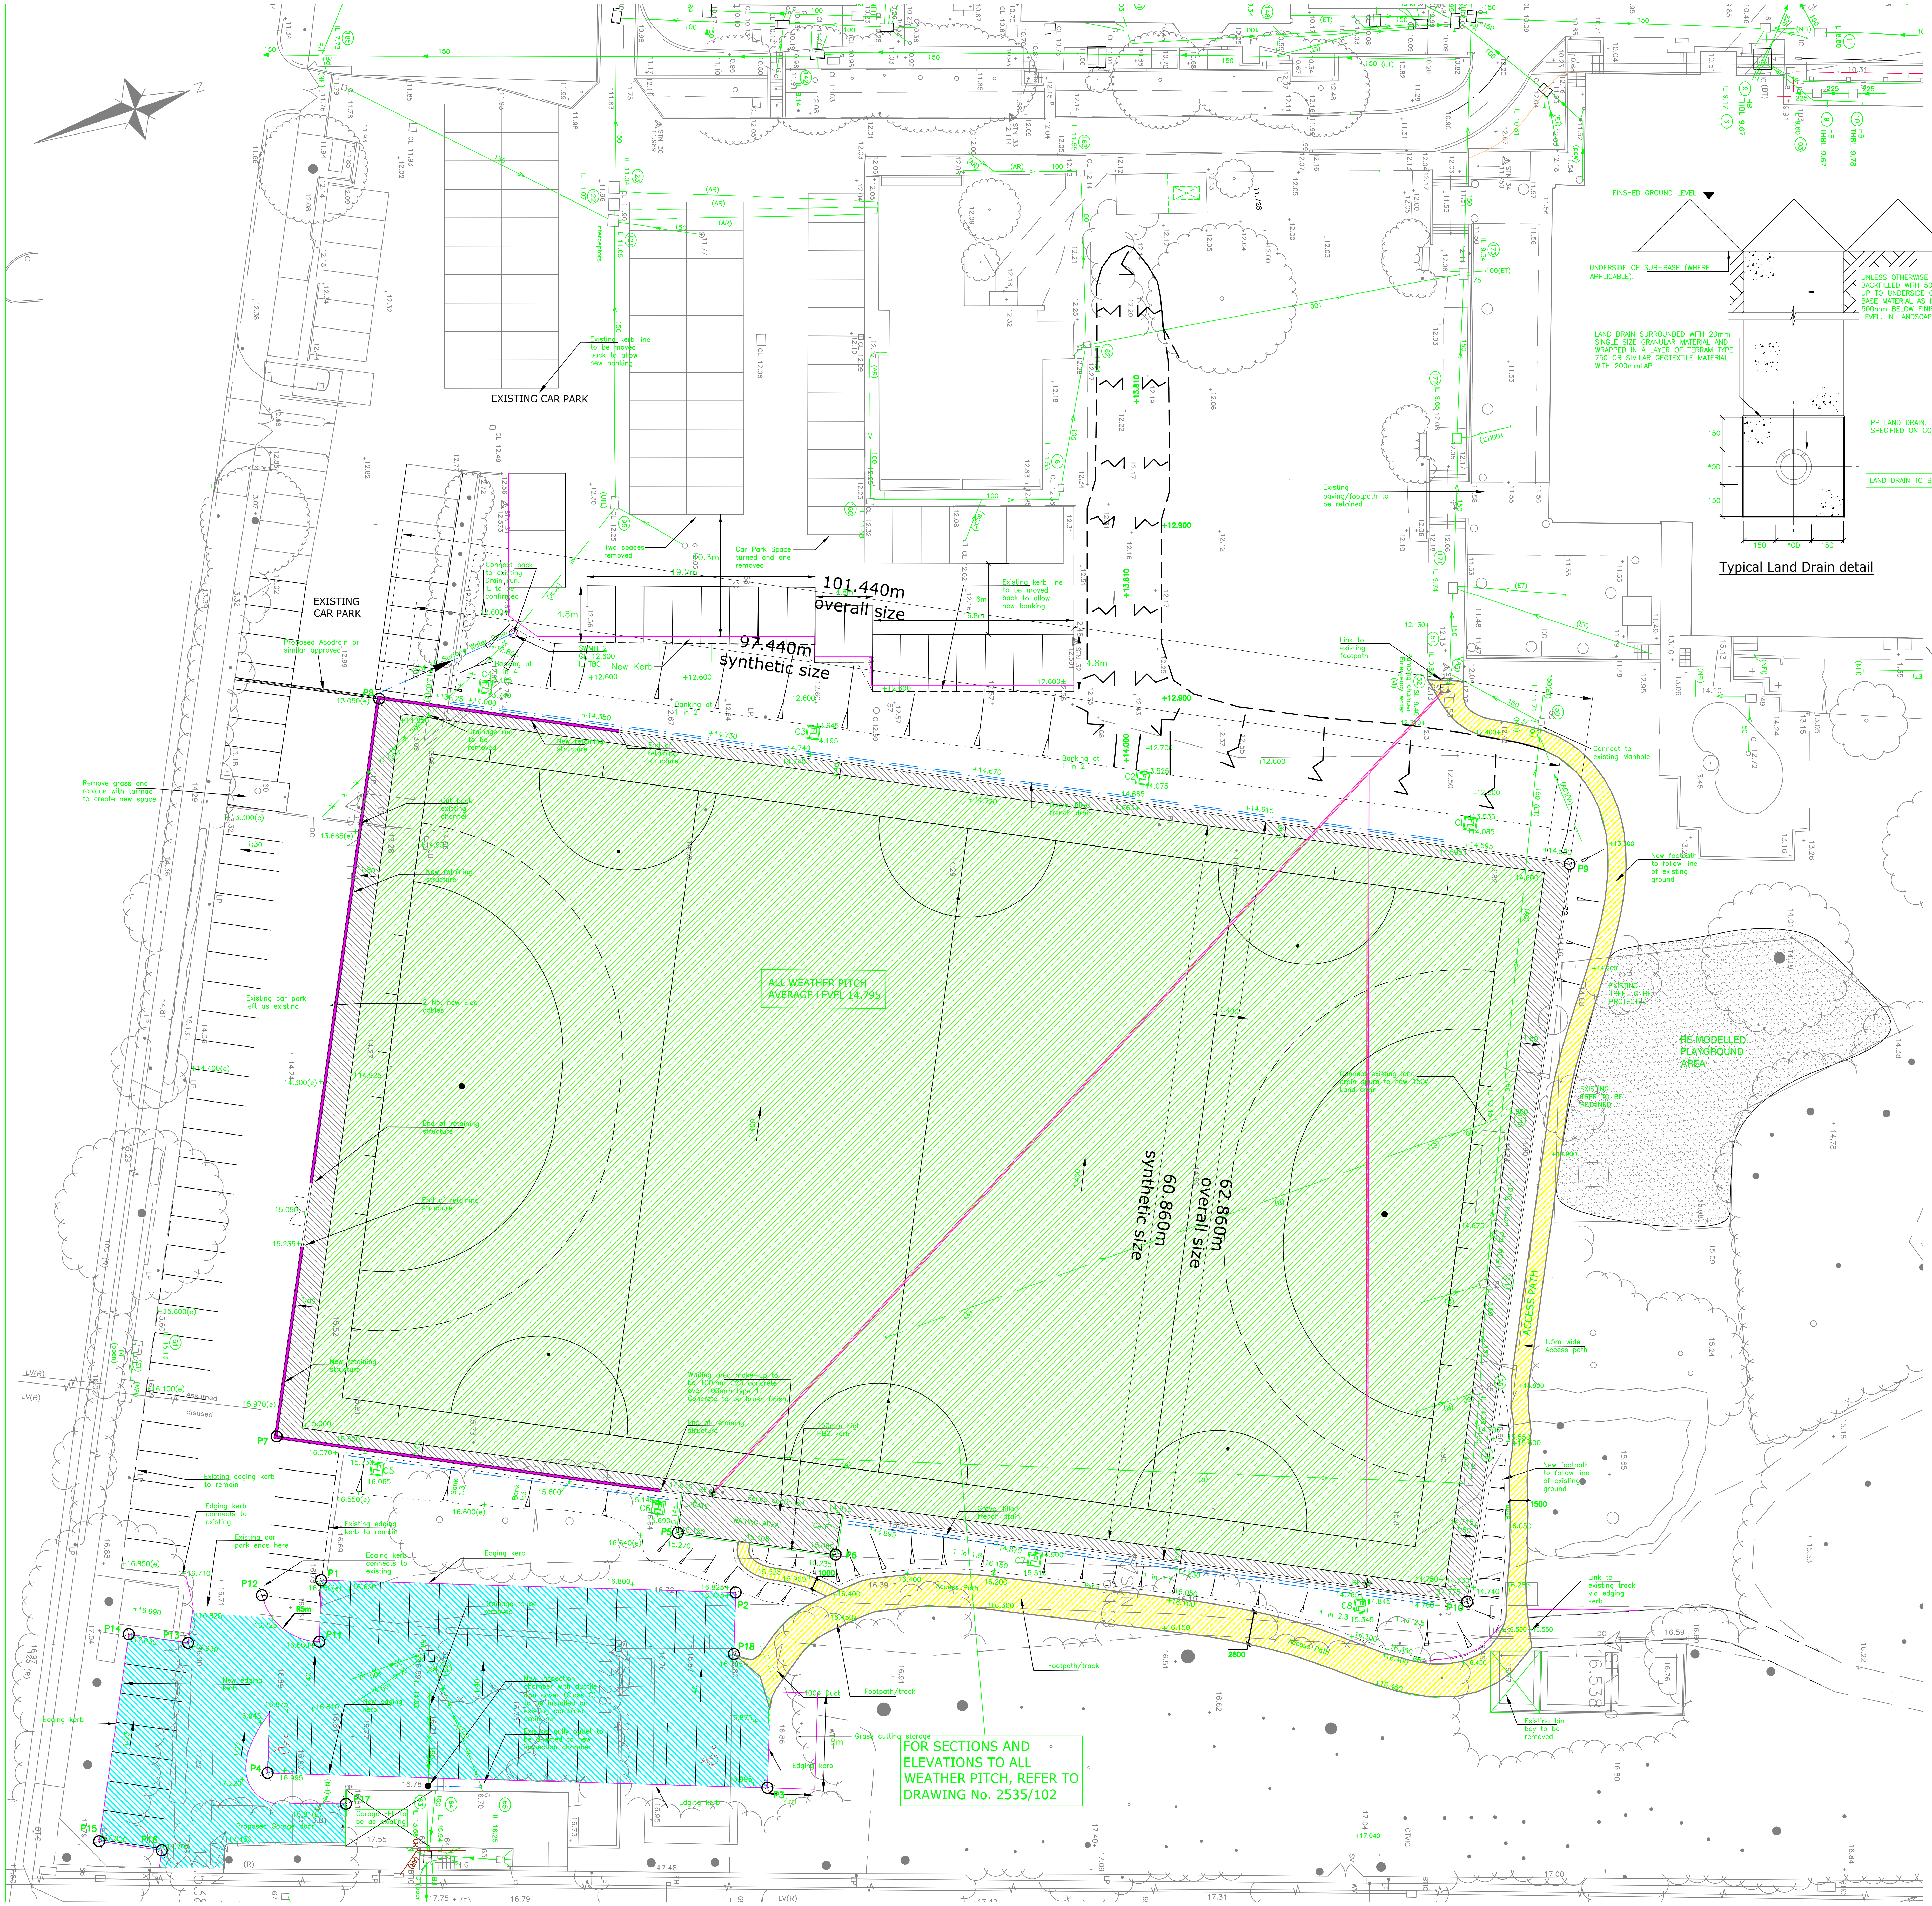
EXISTING CAR PARK
EXISTING CAR PARK
101.440m overall size
97.440m synthetic size
62.860m overall size
60.860m synthetic size
ALL WEATHER PITCH AVERAGE LEVEL 14.795
RE-MODELLED PLAYGROUND AREA
ACCESS PATH
Proposed Acodrain or similar approved
Connect back to existing Drain run. IL to be confirmed
SWMH 2 GL 12.600 IL TBC
New Kerb
Two spaces removed
Car Park Space turned and one removed
Banking at 1 in 4
Banking at 1 in 2
Drainage run to be removed
New retaining structure
End of retaining structure
Cut back existing channel
Waiting area make-up to be 100mm C20 concrete over 100mm type 1. Concrete to be brush finish.
150mm high HB2 kerb
Fence continued
WAITING AREA
GATE
Gravel filled french drain
Access Path
Berm
Footpath/track
100ø Duct
Grass cutting storage
Edging kerb
P1
P2
P3
P4
P5
P6
P7
P8
P9
P10
P12
P13
P14
P15
P16
P18
FINSHED GROUND LEVEL
UNDERSIDE OF SUB-BASE (WHERE APPLICABLE).
UNLESS OTHERWISE STATED TRENCH BACKFILLED WITH 50mm REJECT STONE UP TO UNDERSIDE OF STRUCTURAL SUB BASE MATERIAL AS INDICATED OR 500mm BELOW FINISHED GROUND LEVEL. IN LANDSCAPED AREAS.
LAND DRAIN SURROUNDED WITH 20mm SINGLE SIZE GRANULAR MATERIAL AND WRAPPED IN A LAYER OF TERRAM TYPE 750 OR SIMILAR GEOTEXTILE MATERIAL WITH 200mmLAP
PP LAND DRAIN, TO DIAMETER SPECIFIED ON CONTRACT DRAWINGS.
LAND DRAIN TO BE LAID HOLES UP
150
*OD
150

FOR SECTIONS AND ELEVATIONS TO ALL WEATHER PITCH, REFER TO DRAWING No. 2535/102

Typical Land Drain detail

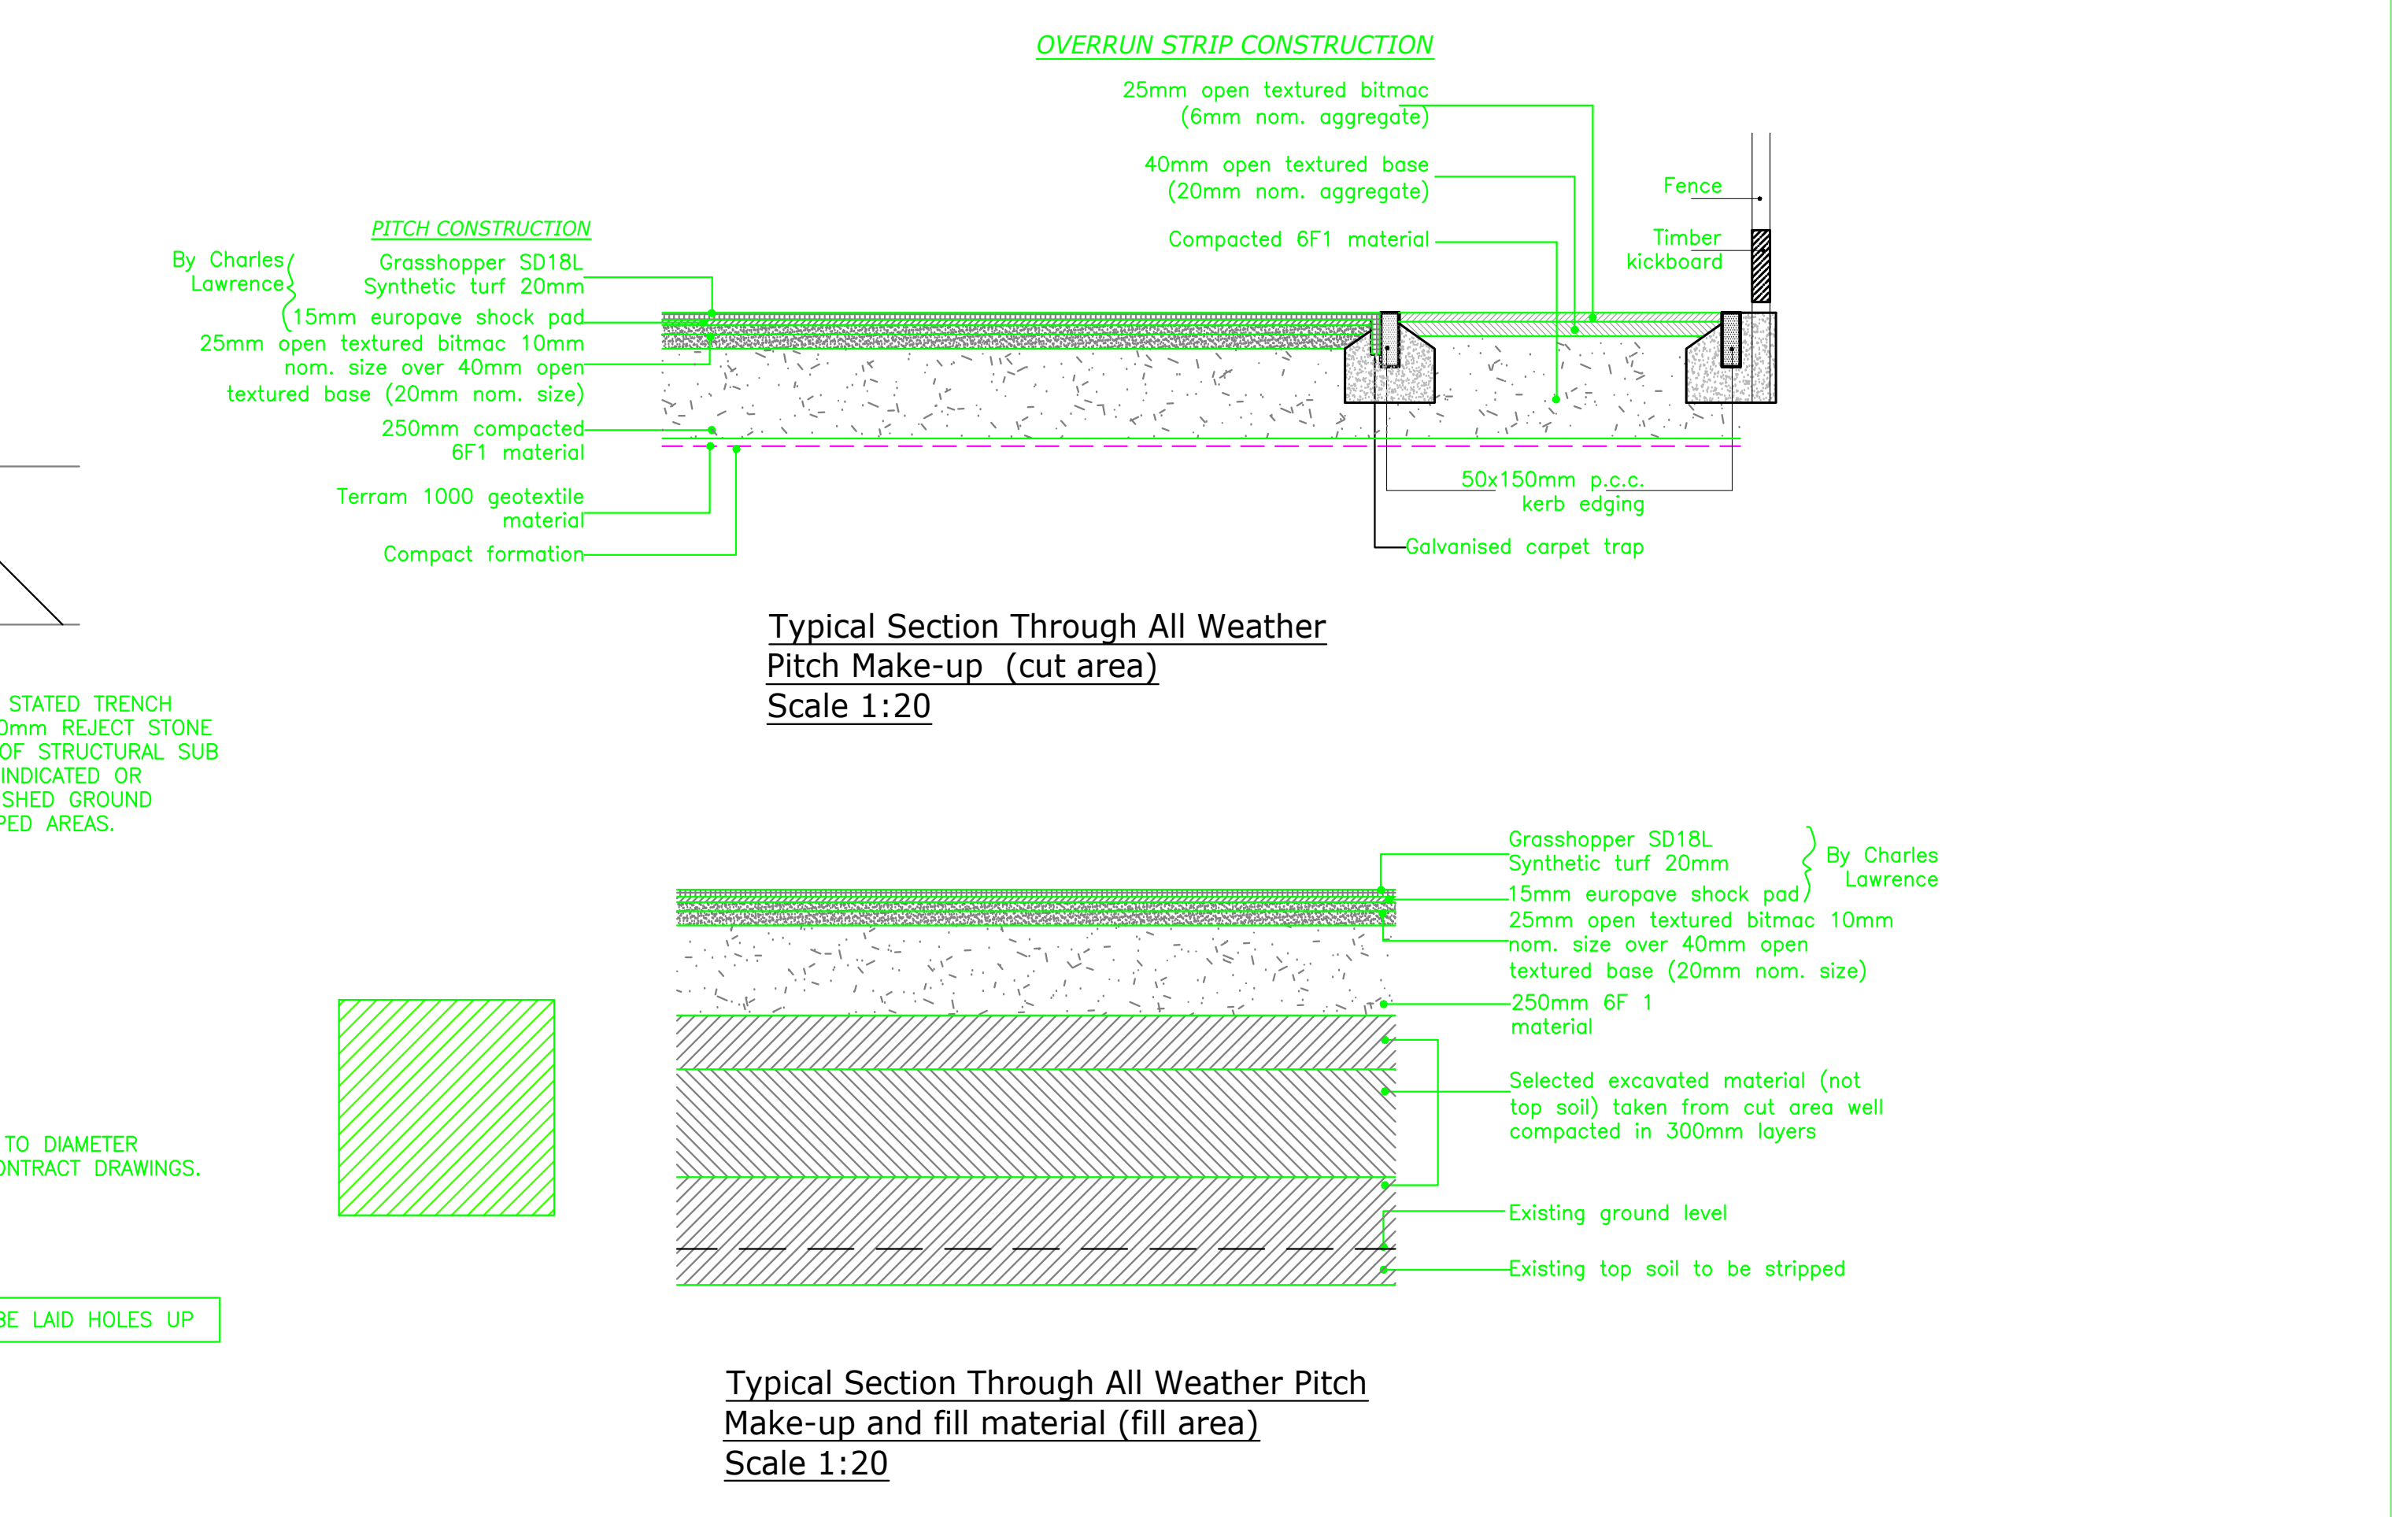
OVERRUN STRIP CONSTRUCTION
25mm open textured bitmac (6mm nom. aggregate)
40mm open textured base (20mm nom. aggregate)
Compacted 6F1 material
Fence
Timber kickboard
PITCH CONSTRUCTION
By Charles Lawrence
Grasshopper SD18L Synthetic turf 20mm
15mm europave shock pad
25mm open textured bitmac 10mm nom. size over 40mm open textured base (20mm nom. size)
250mm compacted 6F1 material
Terram 1000 geotextile material
Compact formation
50x150mm p.c.c. kerb edging
Galvanised carpet trap
250mm 6F 1 material
Selected excavated material (not top soil) taken from cut area well compacted in 300mm layers
Existing ground level
Existing top soil to be stripped

Typical Section Through All Weather Pitch Make-up (cut area)
Scale 1:20

Typical Section Through All Weather Pitch Make-up and fill material (fill area)
Scale 1:20

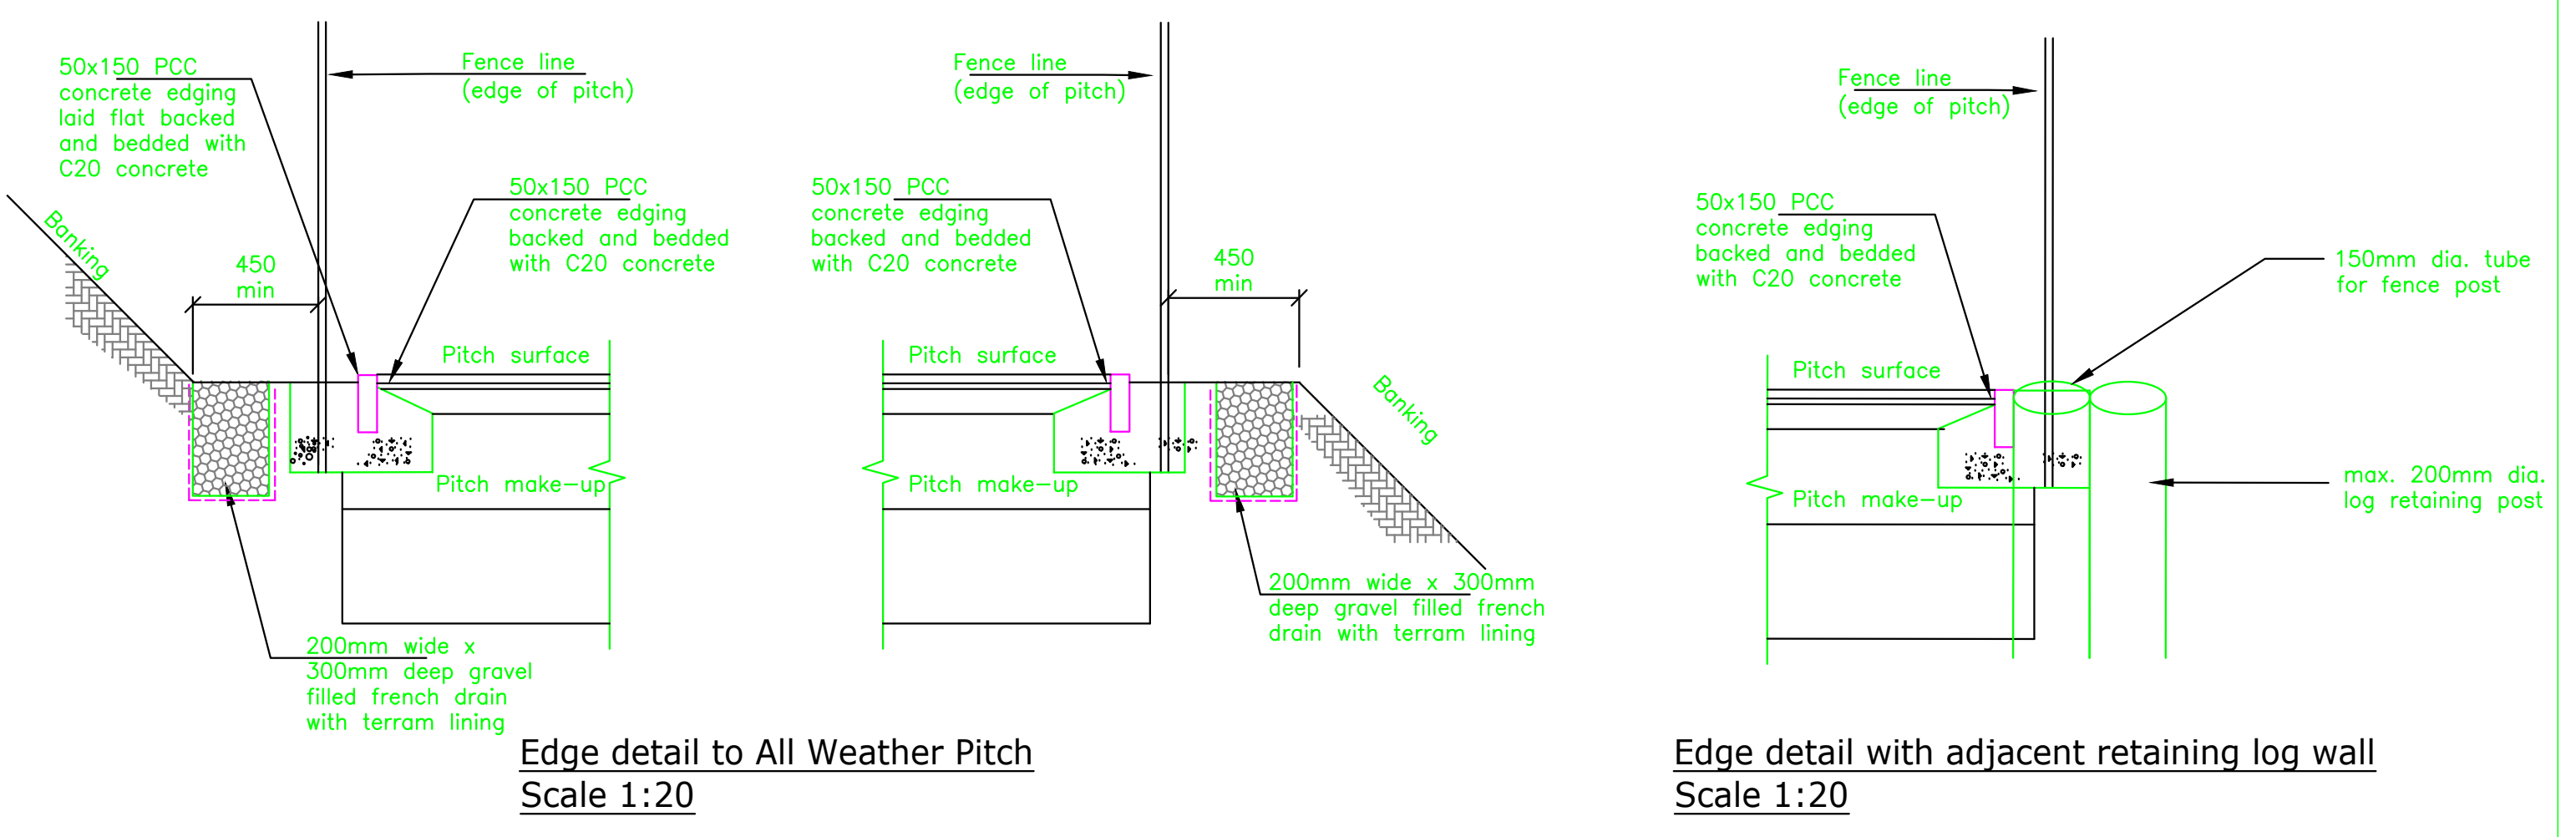
50x150 PCC concrete edging laid flat backed and bedded with C20 concrete
Fence line (edge of pitch)
50x150 PCC concrete edging backed and bedded with C20 concrete
Banking
450 min
Pitch surface
Pitch make-up
200mm wide x 300mm deep gravel filled french drain with terram lining
150mm dia. tube for fence post
max. 200mm dia. log retaining post

Edge detail to All Weather Pitch
Scale 1:20

Edge detail with adjacent retaining log wall
Scale 1:20

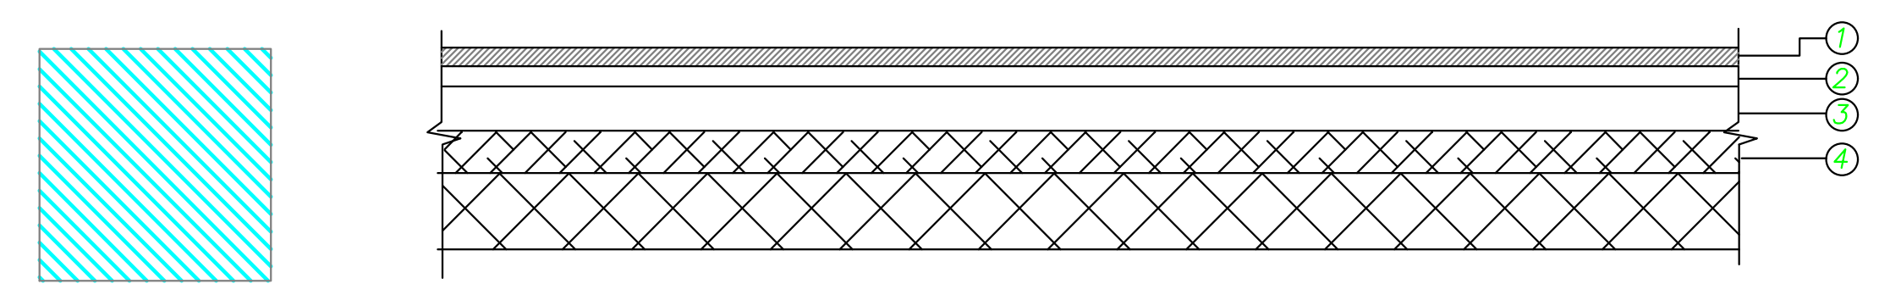

1. 25mm Thick "Tarmac" Permeable Asphalt wearing course
2. 50mm thick "Tarmac" Permeable Asphalt binder course
3. 100mm thick "Tarmac" Permeable Asphalt base course
4. 100mm Sub–base D.O.T. Type 1 material to clause 803
5. 250mm thick capping layer – 6F1 material (75mm max. size)

NEW CAR PARK AREA MAKE-UP

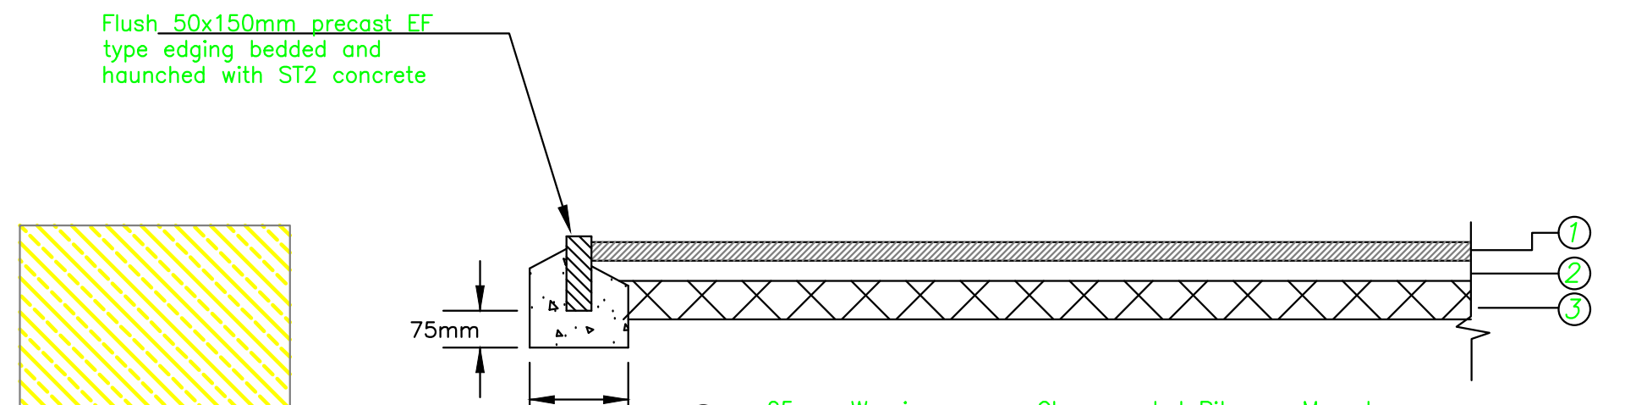
Flush 50x150mm precast EF type edging bedded and haunched with ST2 concrete
75mm
200mm
1
2
3

1. 25mm Wearing course Close graded Bitumen Macadam (6mm nominal size)
2. 50mm base course Close graded Bitumen Macadam Aggregate size 20mm
3. 100mm Sub–Base D.O.T. Type 1 material to Clause 803

NEW ACCESS FOOTPATH

STATION CO–ORDINATES AND LEVELS

STATION	EASTINGS	NORTHINGS	LEVEL
10	521478.889	174757.103	16.538
11	521458.758	174720.911	16.119
12	521450.927	174678.026	17.261
13	521454.566	174640.740	17.538
14	521376.179	174681.481	13.214
15	521415.105	174778.821	13.742
29	521292.400	174743.070	9.851
30	521330.865	174724.977	11.989
31	521356.603	174701.835	12.573
32	521383.961	174743.153	12.591
33	521340.567	174753.294	12.114
34	521358.234	174791.172	11.750
41	521396.679	174771.785	12.100

SETTING OUT CO–ORDINATES

POINT	EASTINGS	NORTHINGS
P1	521436.639	174656.272
P2	521449.582	174688.791
P3	521465.990	174685.667
P4	521450.386	174646.463
P5	521443.175	174685.929
P6	521449.466	174697.810
P7	521423.957	174656.900
P8	521368.404	174686.316
P9	521415.874	174775.964
P10	521471.427	174746.548
P11	521441.470	174654.349
P12	521436.128	174651.141
P13	521437.770	174643.906
P14	521435.383	174639.448
P15	521450.945	174631.120
P16	521453.469	174635.837
P17	521455.093	174651.774
P18	521454.413	174686.868

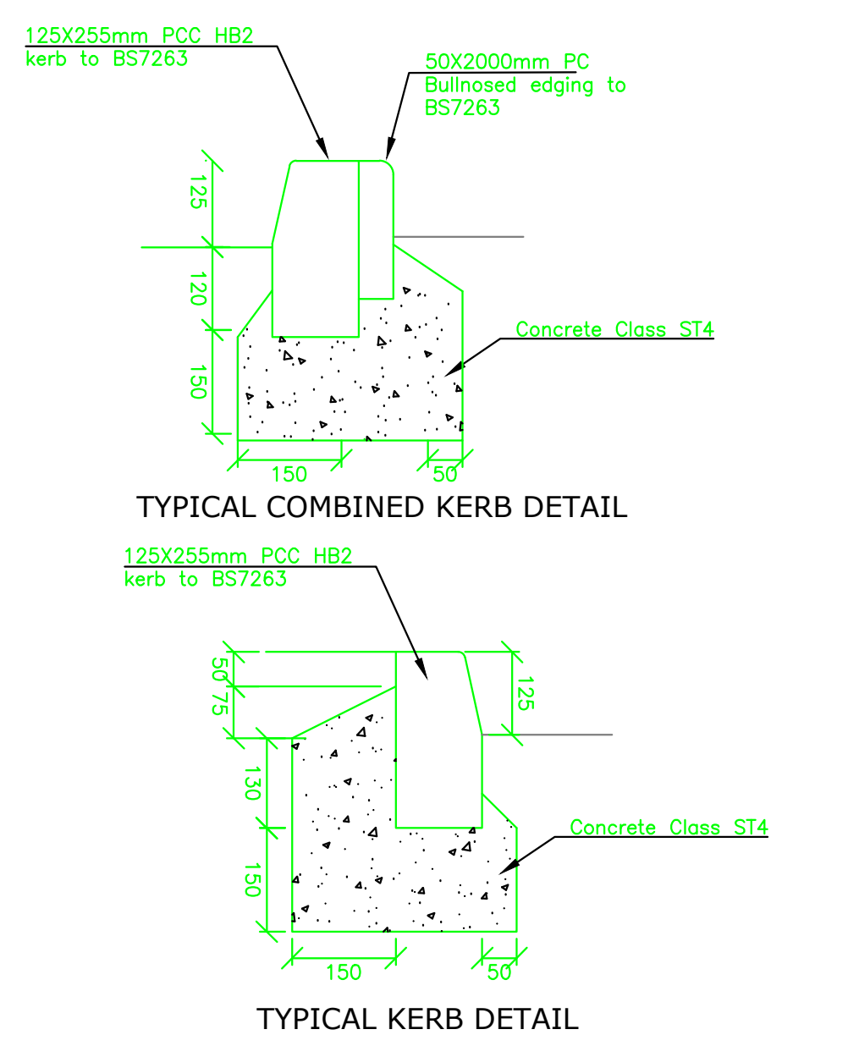
125X255mm PCC HB2 kerb to BS7263
50X2000mm PC Bullnosed edging to BS7263
Concrete Class ST4
125
120
150
150
50
125X255mm PCC HB2 kerb to BS7263
Concrete Class ST4
50
75
125
130
150
150
50

TYPICAL COMBINED KERB DETAIL

TYPICAL KERB DETAIL

Rev	Amendments	Date	Dsn	Chk
	AS INSTALLED	10/01/05	JH	

Status
RECORD DRAWING

Client
B OF E

Architect

Project
ROEHAMPTON
SPORTS GROUND

Title
ALL WEATHER PITCH
& NEW DISABLED ACCESS
EXTERNAL WORKS LAYOUT

Date: FEB 2004
Scale: 1:200
Base Layout Ref.:
CAD File ref.:
Clients Ref.:
Project Ref.: 2535

gta CONSULTING ENGINEERS
MECHANICAL & ELECTRICAL - CIVILS & PUBLIC HEALTH
Unity House, 2 Albert Drive, Burgess Hill, West Sussex, RH15 9TN
Tel.01444 871444 Fax.01444 871401 Web: www.gtagroup.co.uk

Drawing Number: 2535/101
Rev.: