


CIRCULAR PCC MANHOLE DEPTH 1.45m – 3m

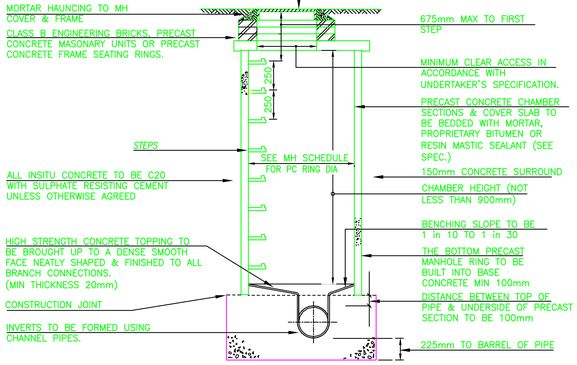

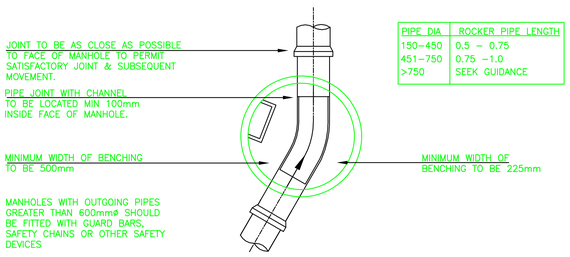


PIPE DIA	ROCKER PIPE LENGTH
150–450	0.5 – 0.75
451–750	0.75 –1.0
>750	SEEK GUIDANCE

BRICK MANHOLE DEPTH LESS THAN 1.0m

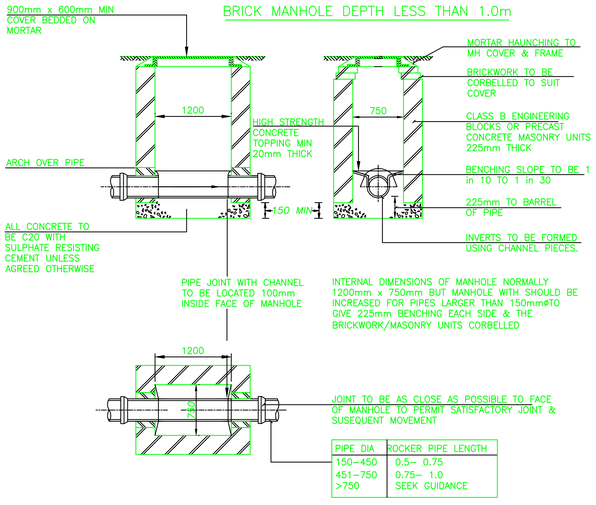


PIPE DIA	ROCKER PIPE LENGTH
150–450	0.5– 0.75
451–750	0.75– 1.0
>750	SEEK GUIDANCE

CLASS B GRANULAR BED

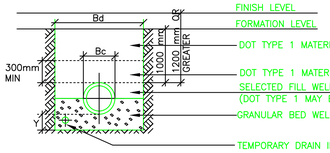

Pipe Size	Trench Width
100 mm	0.6 m
150 mm	0.6 m
225 mm	0.7 m
300 mm	0.8 m
375 mm	1.1 m
400 mm	1.1 m
450 mm	1.2 m
500 mm	1.2 m
600 mm	1.4 m

CLASS S GRANULAR SURROUND

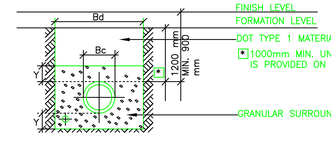

DIMENSION Y = – IN ROCK, CONCRETE OR MIXED SOILS CONTAINING ROCK BANDS, BOULDERS, LARGE FLINTS OR STONES OR OTHER IRREGULAR HARD SPOTS THAT RESULT IN UNEVEN TRENCH BOTTOM Y=1/4 Bc OR 200 mm WHICH EVER IS THE GREATER, BUT NOT LESS THAN 50mm UNDER COLLARS

NOTES – IN SOILS THAT PERMIT AN EVEN TRENCH BOTTOM TO BE EXCAVATED Y=1/6 Bc OR 150 mm WHICH EVER IS GREATER, BUT NOT LESS THAN 50 mm UNDER COLLARS

1) FOR PIPES EXCEEDING 600 mm DIA REFER TO ENGINEER
2) IN WET OR SOFT GROUND SEEK GUIDANCE FROM ENGINEER
3)THE BEDDINGS MAY BE MODIFIED FOR CERTAIN SUB–SOIL CONDITIONS AT THE ENGINEERS DISCRETION
4) THE CONTRACTOR SHALL BE RESPONSIBLE FOR PROVIDING ADDITIONAL PROTECTION IN AREAS SUBJECT TO LOADS FROM SITE TRAFFIC. THE CONTRACTOR SHALL IDENTIFY THESE ZONES AND RESTRICT TRAFFIC ELSEWHERE
5) SEE ALSO BS 8301
6) FOR GREATER TRENCH WIDTHS SEEK GUIDANCE FROM ENGINEER



Manhole schedule

Manhole No.	Eastings	Northings	Type	Internal Diameter	Cover Type	Cover Level	Invert Level	Notes
LTA MH 1.60	521397.608	175033.223	PCC	1800ø	C250	9.465	6.260	Backdrop manhole with Hydrobrake
SWMH3	521386.729	175039.382	PCC	1200ø	C250	9.190	6.200	
SWMH4	521308.488	175082.785	Brick	1200 x 750	C250	7.100	5.820	
SWMH5	521303.859	175074.574	Brick	1200 x 750	C250	7.000	5.780	
SWMH6	521215.774	175123.701	Brick	1200 x 750	C250	6.400	5.350	
OUTFALL	521205.755	175138.311	Outfall	N/A	N/A	N/A	5.275	For detail of outfall refer to Arup Drg no. INF/4102

Notes

1. The location, size, depth and identification of existing services that may be shown or referred to on this drawing have been assessed from non intrusive observations , record drawings or the like. The contractor shall safely carry out intrusive investigations, trial holes or soundings prior to commencing work to satisfy himself that it is safe to proceed and that the assessments are accurate. any discrepancies shall be notified to gta prior to works commencing.

2. Tender or billing drawings shall not be used for construction or the ordering of materials.

3. This drawing to be read in conjunction with all other mechanical and electrical drawings and specifications.

Legend/Abbreviations

	FD	FOUL DRAIN
	SWD	SURFACE WATER DRAIN
	MH	MANHOLE
	IC	INSPECTION CHAMBER
	CI	CAST IRON
	VC	VITRIFIED CLAY
	CONC	CONCRETE
	PVC–U	POLYVINYL CHLORIDE – UNPLASTICISED
○	G	GULLY D209.0
▨	RG	ROAD GULLY D208.1
◎	YG	YARD GULLY D209.2
	KG	KITCHEN WASTE GULLY D209.1
✦	RP	RODDING POINT D213.1
◆	DP	DRAIN POINT
	SVP	SOIL VENT PIPE D307.1
	SS	STUB STACK D307.0
	VP	VENT PIPE
◆	RWP	RAINWATER PIPE D203.0
	FFL	FINISHED FLOOR LEVEL
	SSL	STRUCTURAL SLAB LEVEL
	GL	GROUND LEVEL
	CL	COVER LEVEL
	IL	INVERT LEVEL
	BD	BACKDROP
	CBS	Concrete Bed & Surround
	Class S	Granular Bed & Surround
	Class B	Granular Bed

Rev	Amendments	Date	Dsn	Chk
	AS INSTALLED Record Drawings produced from information provided by principal contractor	10/01/05	JH	

Status: RECORD DRAWING

Client: B OF E

Architect:

Project: ROEHAMPTON SPORTS GROUND

Title: B of E/ LTA BOUNDARY, DRAINAGE LAYOUT AND DETAILS

Date	Scale
JUNE 2004	1:500
Base Layout Ref.	CAD File ref.
Clients Ref.	Project Ref. 2535

gta CONSULTING ENGINEERS
MECHANICAL & ELECTRICAL - CIVILS & PUBLIC HEALTH
Unity House, 2 Albert Drive, Burgess Hill, West Sussex, RH15 9TN
Tel.01444 871444 Fax.01444 871401 Web: www.gtagroup.co.uk

Drawing Number	Rev.
2535/117	