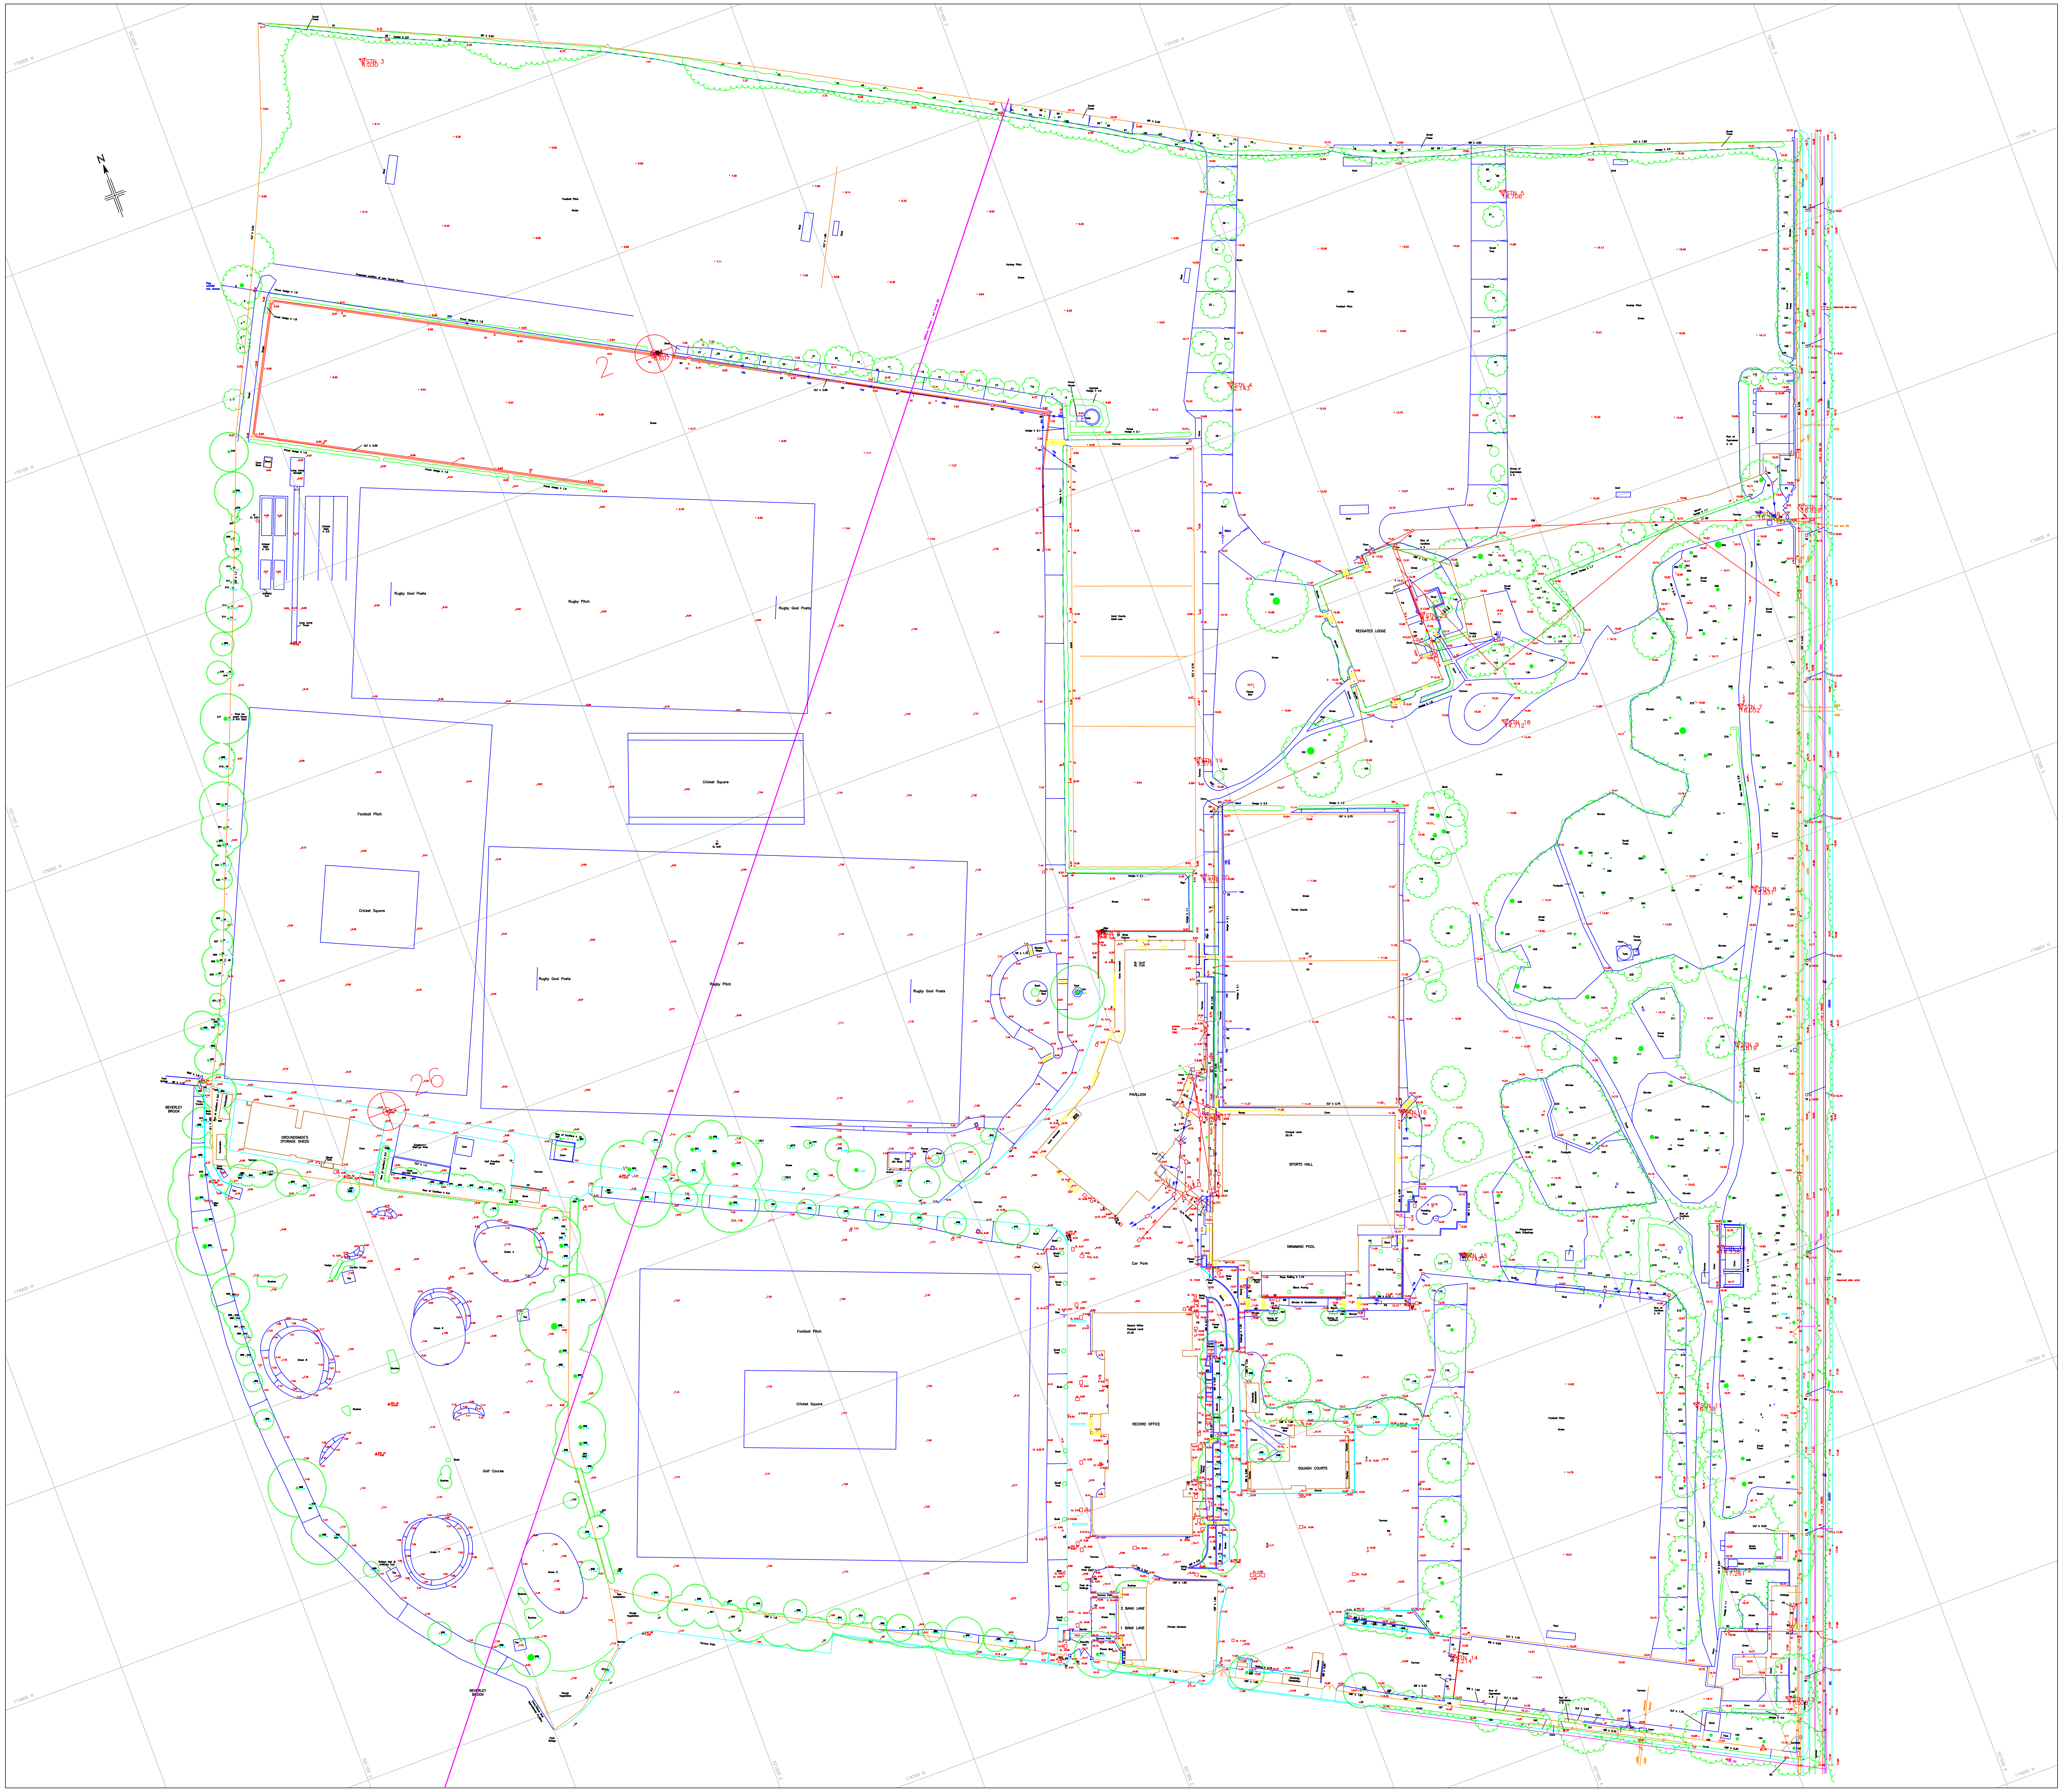

ABBREVIATIONS

(AC)	Assumed Connection
BdL	Backdrop Level
BT	Britich Telecom
BW	Brick Wall
BTIC	British Telecom IC
CBF	Close Boarded Fence
CL	Cover Level
CLF	Chain Link Fence
Conc	Concrete
CTV	Cable Television
CV	Control Valve
CW	Concrete Wall
DC	Drainage Channel
(dis)	disused
DT	Disconnecting Trap
ECP	Electric Cable Pit
EL	Eaves Level
ER	Earth Rod
FH	Fire Hydrant
Flt	Flood Light
G	Gully
GP	Gully Pot
GV	Gas Valve
h	Height
HBL	Hatch Box Level
HR	Hand Rail
IC	Inspection Cover
IL	Invert Level
IRF	Iron Railings Fence
JB	Junction Box
LP	Lamp Post
LV	Low Voltage
MH	Manhole
Mkr	Marker
MP	Medium Pressure (Gas)
(NFI)	No Further Information
O/H	Overhead
PL	Pedestrian Light
PS	Paving Slabs
(R)	From Records
RL	Ridge Level
RS	Road Sign
S	Stump
SC	Stop Cock
SV	Stop Valve
TP	Telephone Pole
(UTL)	Unable To Lift without damage
WT	Water Tap
WV	Water Valve
WW	Wooden Wall

LEGEND

→ ALL ARROWS POINT UP UNLESS OTHERWISE STATED

- FOUL DRAINAGE
- SURFACE WATER DRAINAGE
- WATER
- GAS
- ELECTRICITY
- TELEPHONE
- CABLE TV

ELECTRO–DETECTION TECHNIQUES HAVE BEEN USED IN THE LOCATION OF UNDERGROUND SERVICES. THE RESULTS ARE NOT INFALLIBLE AND TRIAL EXCAVATIONS MUST BE CARRIED OUT TO CONFIRM SERVICE IDENTIFICATION, POSITION AND PARTICULARLY DEPTHS.
ALTHOUGH ALL REASONABLE EFFORT HAS BEEN MADE IN SEARCHING AVAILABLE RECORD DRAWINGS THE COMPLETENESS OF THE UNDERGROUND SERVICES INFORMATION CANNOT BE GUARANTEED.

UNLESS OTHERWISE STATED, DRAINAGE PIPES ARE 100mm DIAMETER.

DRAWING ISSUE STATUS

Issue	Details	By	Date
A	ORIGINAL ISSUE	PCA	25/05/01
B	SPORTS PITCHES ADDED	PCA	04/02/03

SHEET LAYOUT

THIS SURVEY HAS BEEN CARRIED OUT TO AN ACCURACY CONSISTENT WITH A PRESENTATION SCALE OF 1:200 INTERROGATED DIMENSIONS WILL BE WITHIN THE TOLERANCE ASSOCIATED WITH THIS AND SMALLER SCALES ONLY.

ALL LEVELS IN METRES, RELATED TO NEWLYN DATUM BASED UPON OSBM VALUE 10.95m SITUATED ON WEST FACE OF RECORD OFFICE COTTAGES, BANK LANE.

SURVEY BASED ON OS NATIONAL GRID.

THIS DRAWING INCORPORATES DRAWING 6865–1.

BANK OF ENGLAND
SPORTS GROUND
ROEHAMPTON

SITE SURVEY

SURVEYED AND DRAWN BY
Plowman Craven & Associates
141 Lower Luton Road
Harpenden
Hertfordshire.
AL5 5EQ.
Tel: (01582) 765566
Fax: (01582) 765370
email: post@plowcrav.demon.co.uk

PCA

SCALE NOT TO SCALE

DATE OF ISSUE FEBRUARY 2003

PCA JOB No. 7896 | CHECKED JFS

DRAWING No. 7289–1 | ISSUE B