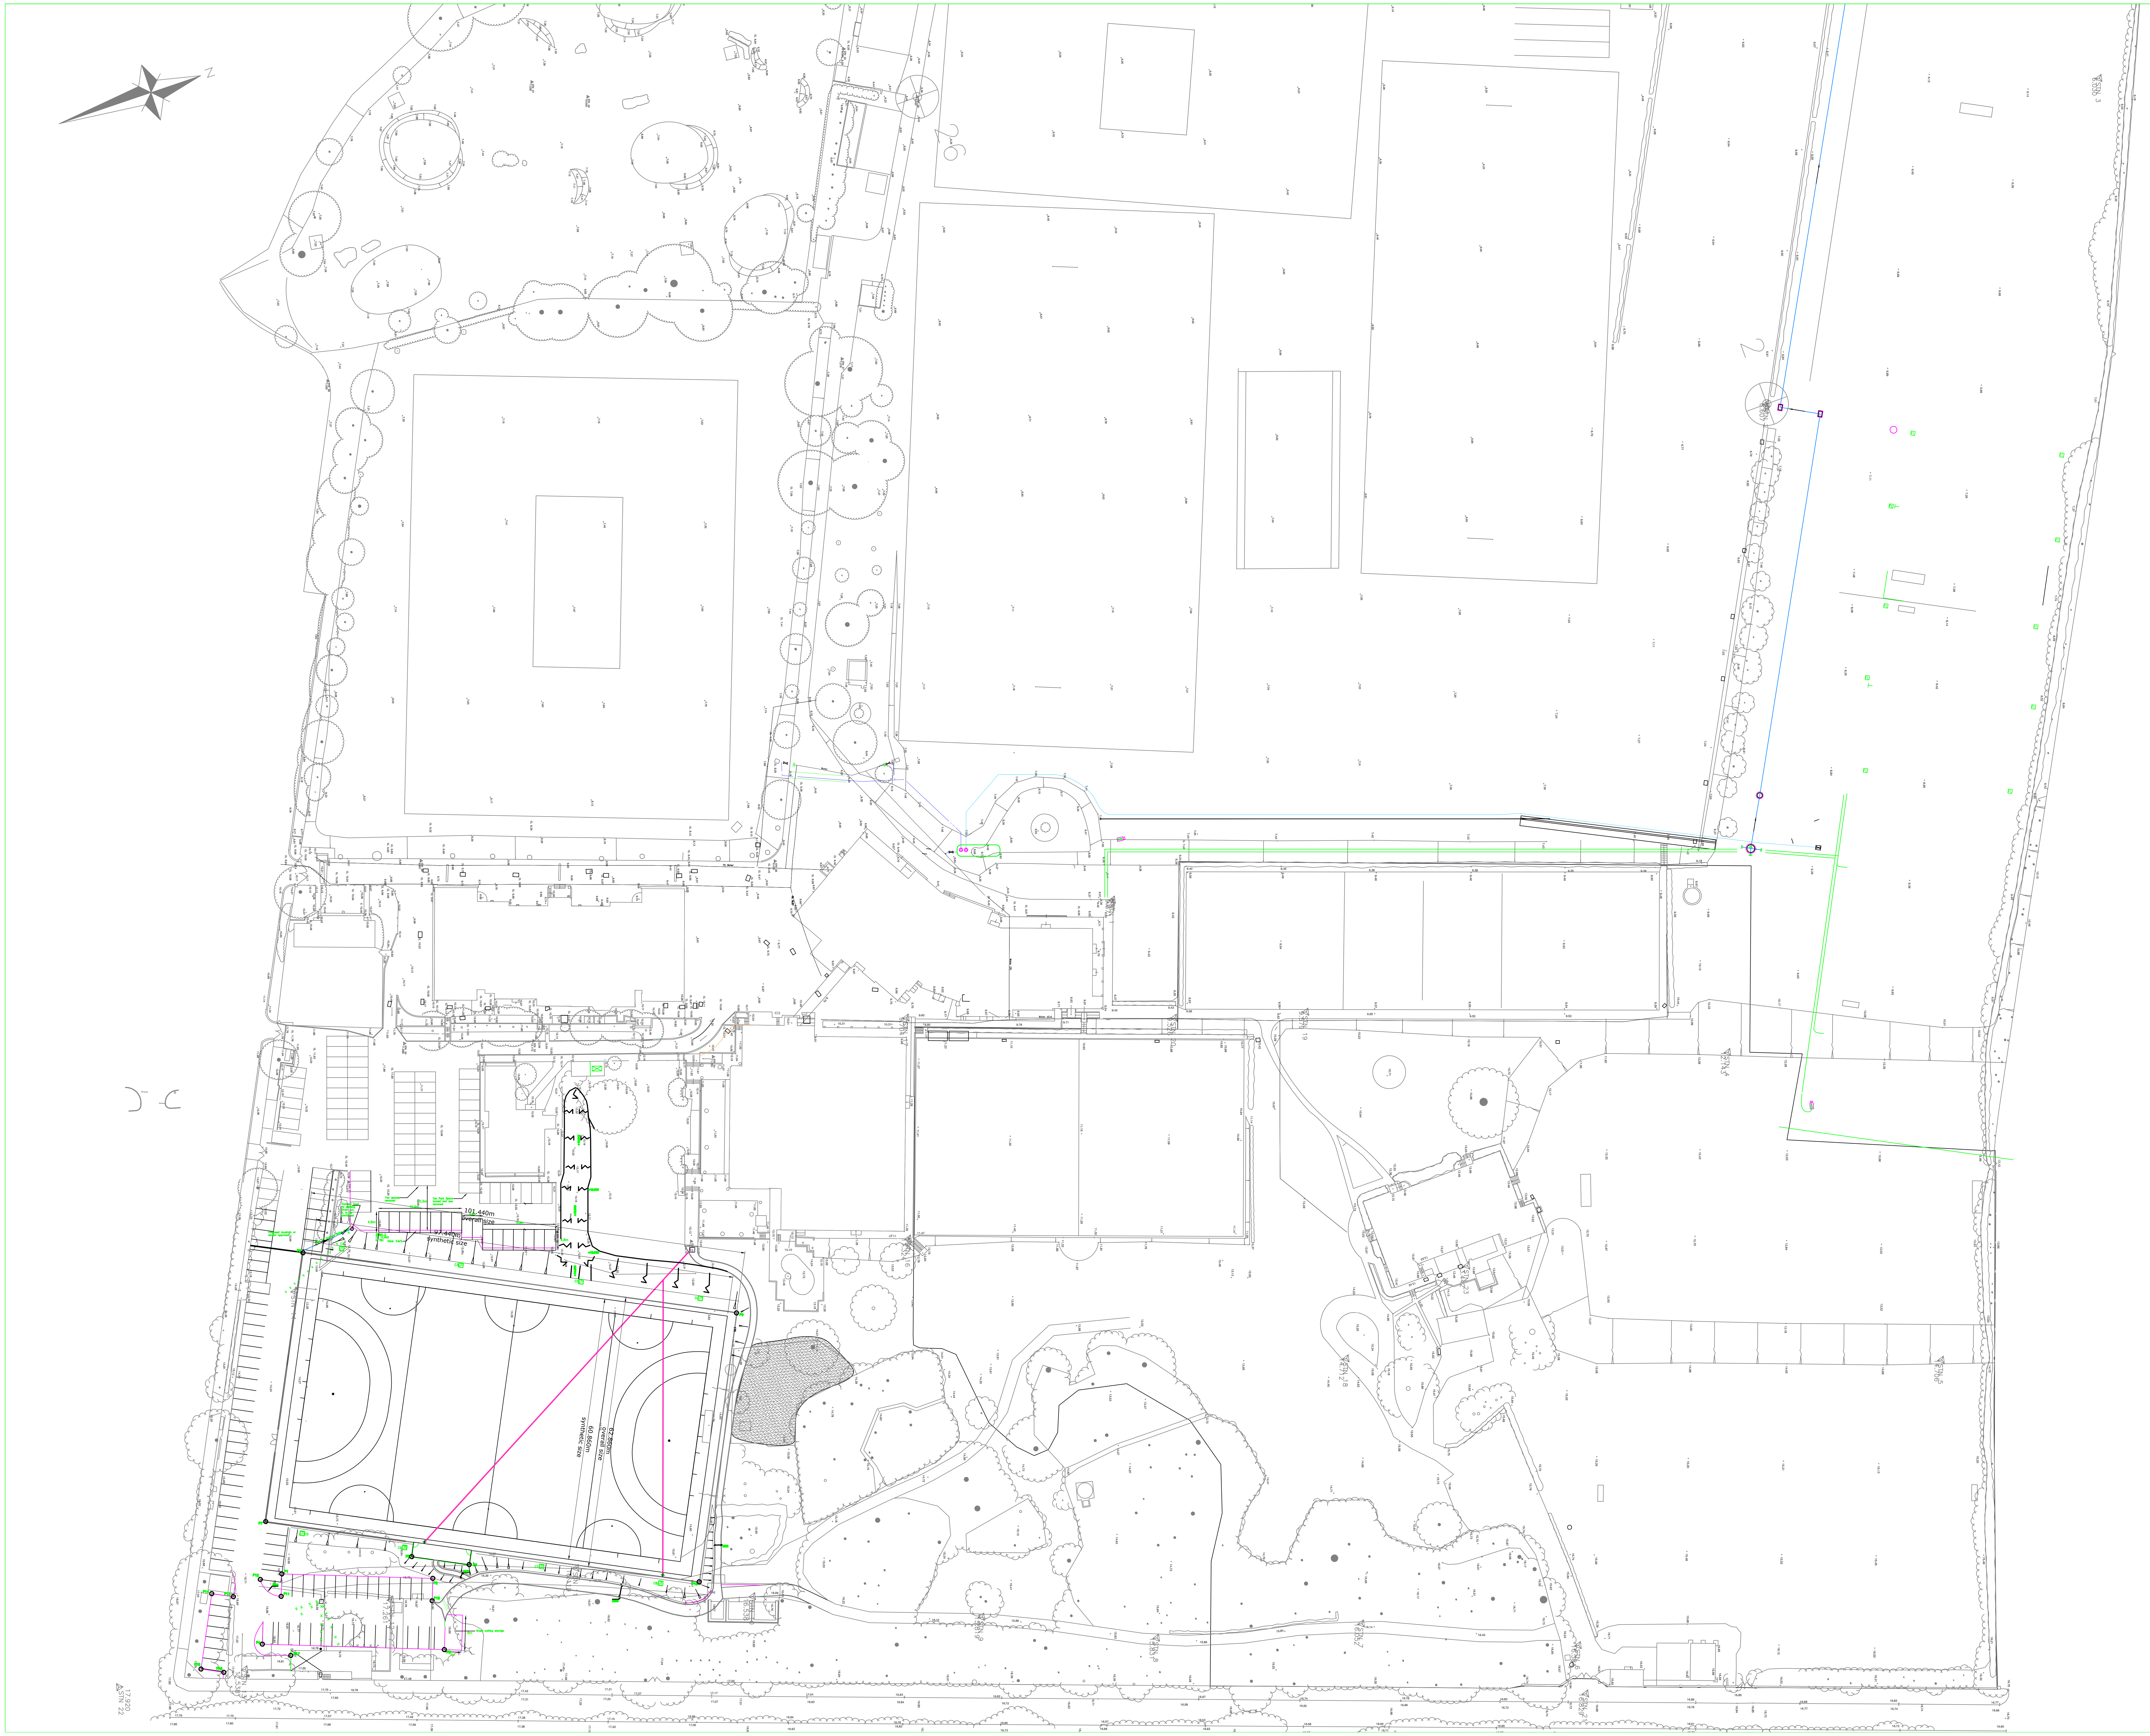

Rev	Amendments	Date	Dsn	Chk
	AS INSTALLED	10/01/05	JH	

Status
RECORD DRAWING

Client
B OF E

Architect

Project
ROEHAMPTON
SPORTS GROUND

Title
OVERALL SITE
LAYOUT

Date FEB 2004	Scale 1:500
Base Layout Ref.	CAD File ref.
Clients Ref.	Project Ref. 2535

gta CONSULTING ENGINEERS
MECHANICAL & ELECTRICAL - CIVILS & PUBLIC HEALTH
Unity House, 2 Albert Drive, Burgess Hill, West Sussex, RH15 9TN
Tel.01444 871444 Fax.01444 871401 Web: www.gtagroup.co.uk

Drawing Number 2535/100	Rev.